




**AMERICAN VERNACULAR**  
 151 Sheppard St.  
 Charleston  
 South Carolina  
 29403  
 843-856-4818  
 www.americanvernacular.com

ISSUES/REVISIONS	
2/16/22	AS-BUILTS

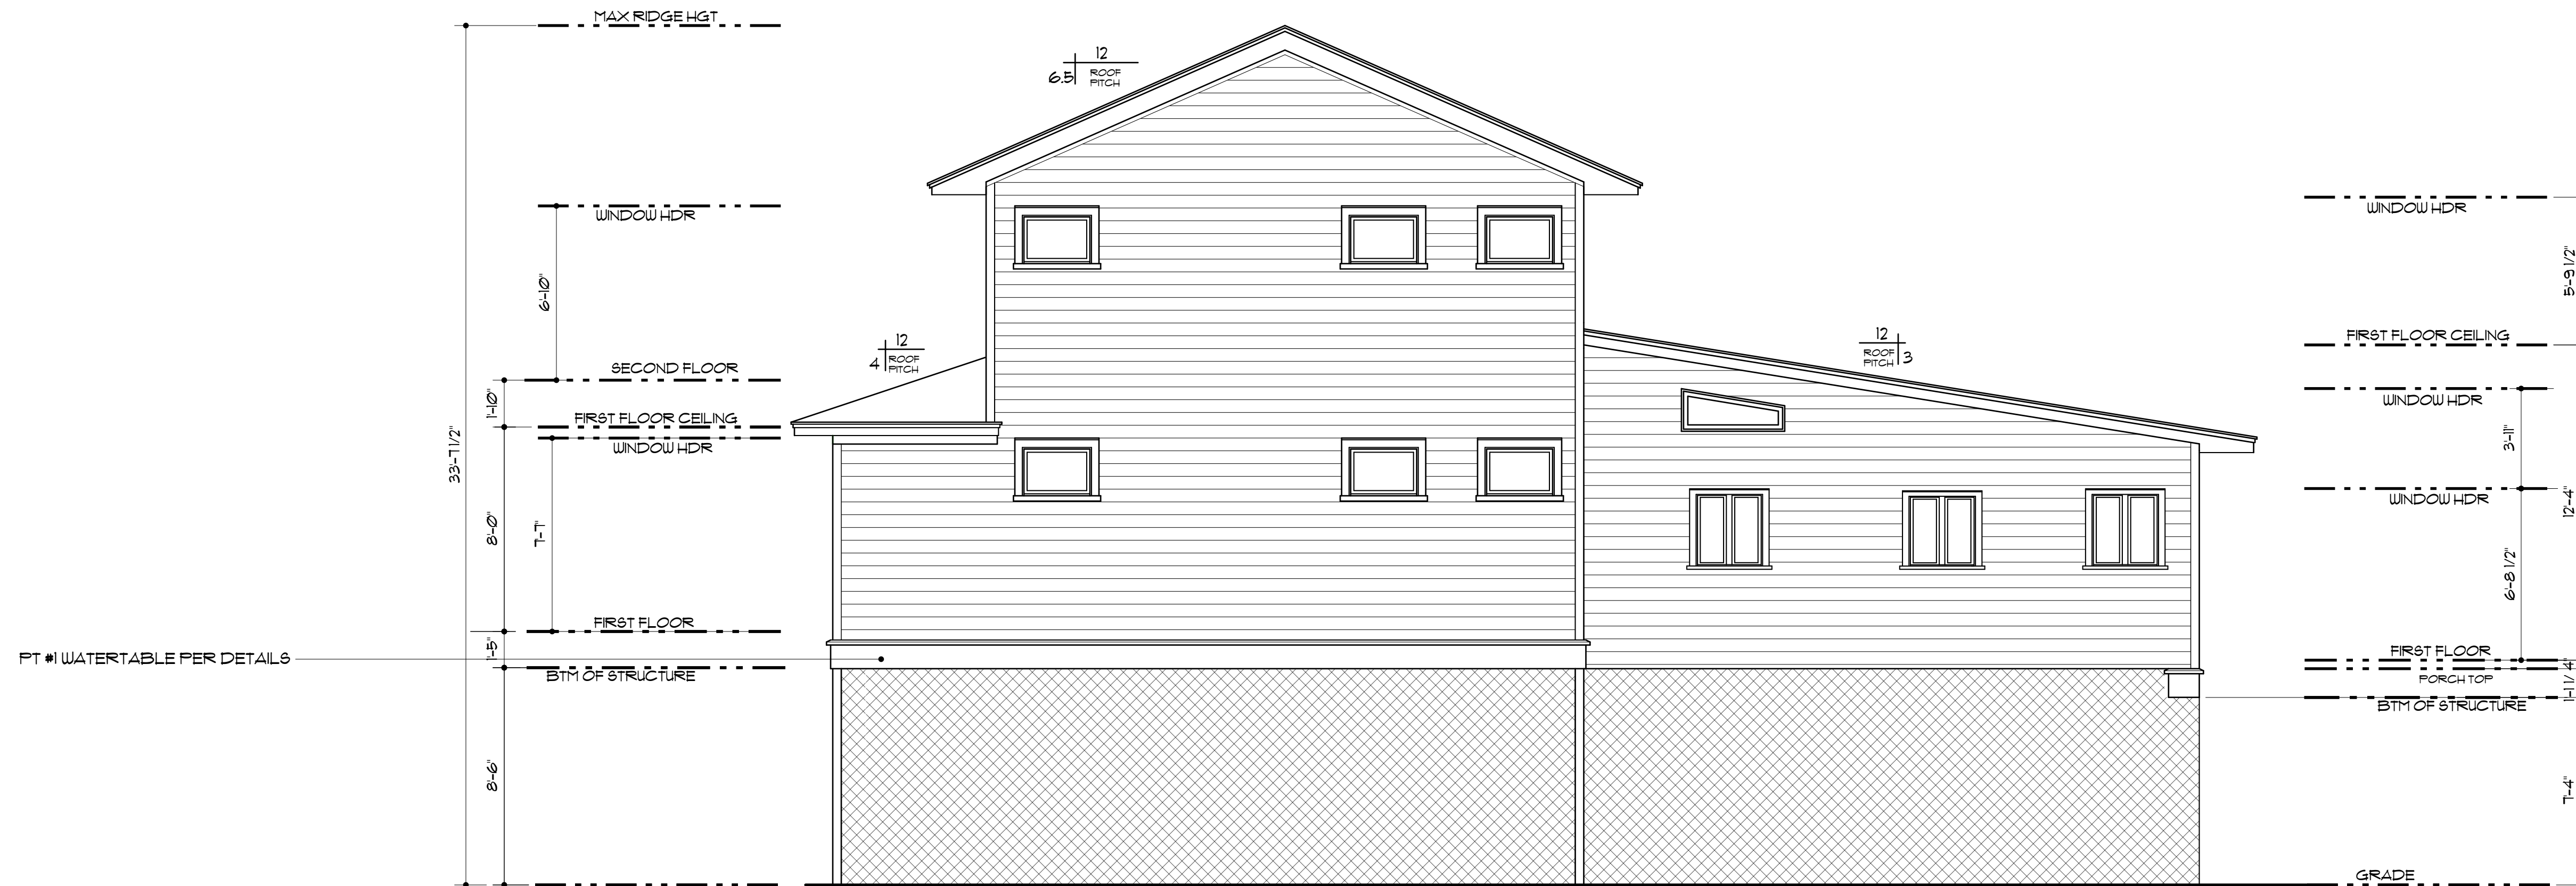

1 SIDE ELEVATIONS - AS BUILTS  
 A103 SCALE: 1/4" = 1'-0"

*Dunn Residence*  
 2923 Ion Ave  
 Charleston, South Carolina

EXTERIOR ELEVATIONS AS BUILTS

DRAWINGS AND THE DESIGN ARE THE PROPERTY OF THE DESIGNER WHETHER THE PROJECT FOR WHICH THEY ARE PREPARED IS EXECUTED OR NOT. THE DRAWINGS SHALL NOT BE USED BY THE PROJECT OWNER OR ANYONE ELSE FOR ANY OTHER PROJECT. THESE DRAWINGS CANNOT BE CHANGED OR REPRODUCED WITHOUT WRITTEN APPROVAL OF DESIGNER.

SCALE: 1/4" = 1'-0"

DATE: February 16, 2022

EXTERIOR ELEVATIONS AS BUILTS

A202